

CHAPTER 8

ROAD MARKINGS & SIGNS




DRAWING TITLE	DRAWING NO.	REVISION
LANE MARKINGS (SHEET 1 OF 3)	LTA/SDRE14/8/RMS1	D
LANE MARKINGS (SHEET 2 OF 3)	LTA/SDRE14/8/RMS2	B
LANE MARKINGS (SHEET 3 OF 3)	LTA/SDRE14/8/RMS3	A
ARROW MARKINGS	LTA/SDRE14/8/RMS4	A
MULTI-HEAD ARROW FOR TURNING MOVEMENTS	LTA/SDRE14/8/RMS5	A
TYPICAL ACCELERATION LANE AT EXPRESSWAY	LTA/SDRE14/8/RMS6	B
TYPICAL DECELERATION LANE AT EXPRESSWAY	LTA/SDRE14/8/RMS7	B
CHEVRON MARKINGS	LTA/SDRE14/8/RMS8	A
ROAD SIGNS & MARKINGS AT INTERSECTIONS	LTA/SDRE14/8/RMS9	F
BUS LANE MARKINGS AND ALTERNATIVE TRAFFIC (TURN ON GREEN ARROW)		
SIGNAL PLACEMENT	LTA/SDRE14/8/RMS10	D
MANDATORY GIVE WAY TO BUS (MGWTB)	LTA/SDRE14/8/RMS11	-
PAVEMENT MARKINGS FOR SHARP CURVE	LTA/SDRE14/8/RMS12	A
CURVE ALIGNMENT MARKERS (CAM)	LTA/SDRE14/8/RMS13	-
GUIDING LINES AND TURNING POCKETS AT INTERSECTIONS	LTA/SDRE14/8/RMS14	B

NOTES: 1. Single / double yellow lines are not required under the following situations: - flyover and underpass - ramps leading to flyover and underpass - slip road (both sides) - edge of traffic island (forming the slip road) at road intersection 2. Thermoplastic road marking materials shall comply with SS 589:2013.	3. The dimensioning lane width shall be taken from the centre of lane markings. See diagram A 																																																																																																																																																																																																																																																																																																																																																																																																																																																																																																																																																																																																																																																																																																																																																																																																																																																																																																																																																																																																																																																																																																																																																																																																																																																																																																																														
--	---	--	--	
TYPE	MARKINGS	DESCRIPTION	THICKNESS OF THERMOPLASTIC PAINT (mm)
O		Single zig zag yellow line at the edge of a road prohibiting parking at all times.	1.5
P		Double zig zag yellow line at the edge of a road prohibiting stopping of vehicles at all times unless the vehicle is prevented from proceeding due to traffic conditions.	1.5
Q		These continuous yellow & red lines are used as full day bus lane marking.	1.5 (Yellow Line) 1.5 (Red Line)
R		Raised profile marking to be provided for the following: - From the start of the shoulder marking at the exit road to 10m behind the gore area - From the start of chevron to 10m after the gore area - From the start of the deceleration lane along expressway next to paved shoulder - Continuously along the expressway shoulder lane next to slow lane	

OTHER ROADS SCALE 1:200	FULL DAY BUS LANE SCALE 1:200	NORMAL BUS LANE SCALE 1:200	EXPRESSWAY / TUNNEL LANE SCALE 1:200


STANDARD DETAIL		Land Transport Authority	
LANE MARKINGS (SHEET 3 OF 3)		DRAWING NO. LTA/SDRE14/8/RMS3	REV. A
A OCT 2015		DATE OF ISSUE 1st APR 2014	SHEET NO. 3 OF 3
REV. DATE		SCALE AS SHOWN	

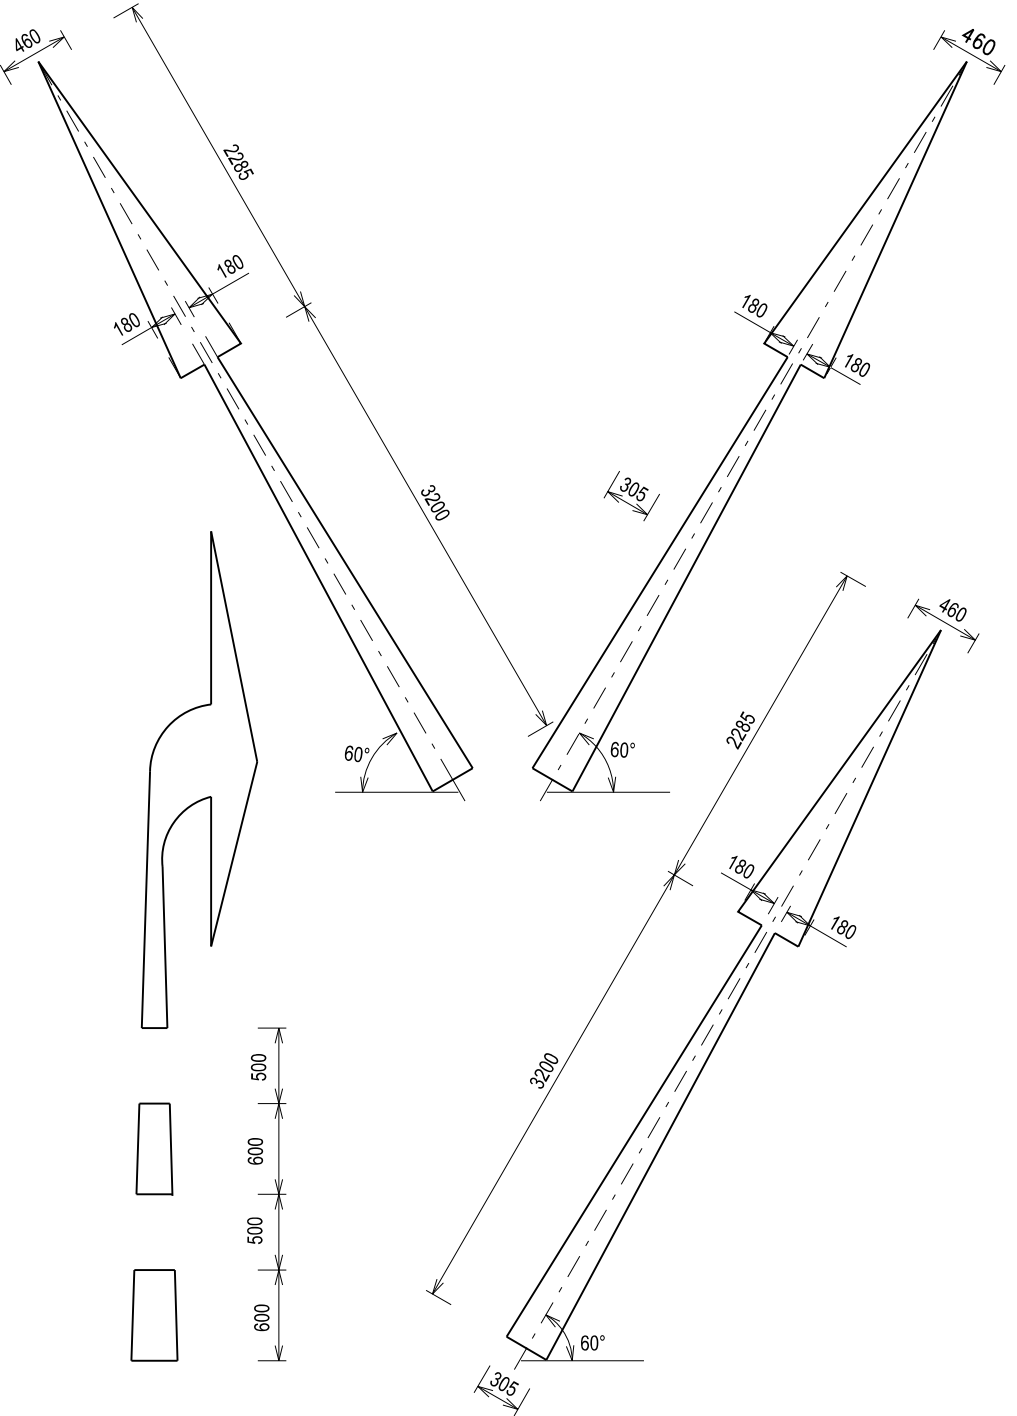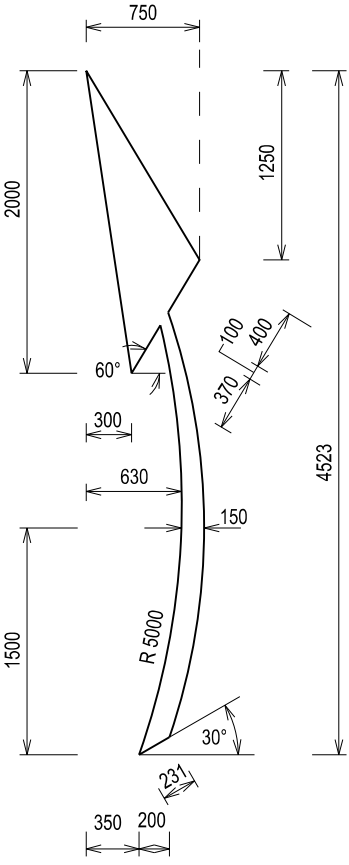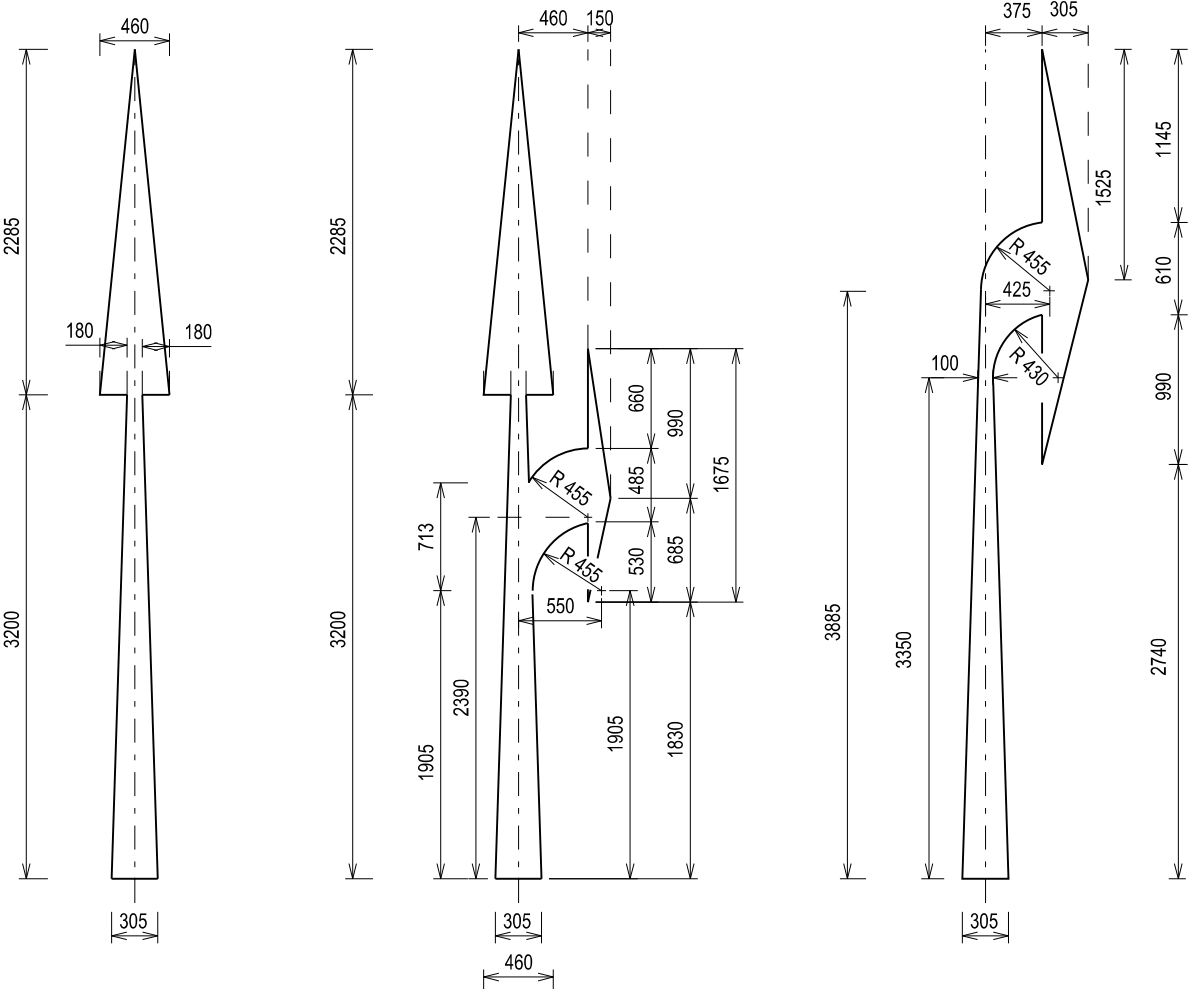


TO INDICATE CERTAIN
TRAFFIC MOVEMENT
WITH TIME LIMIT

NOTES:
1. Thickness of thermoplastic paint is 3mm.

--	--	
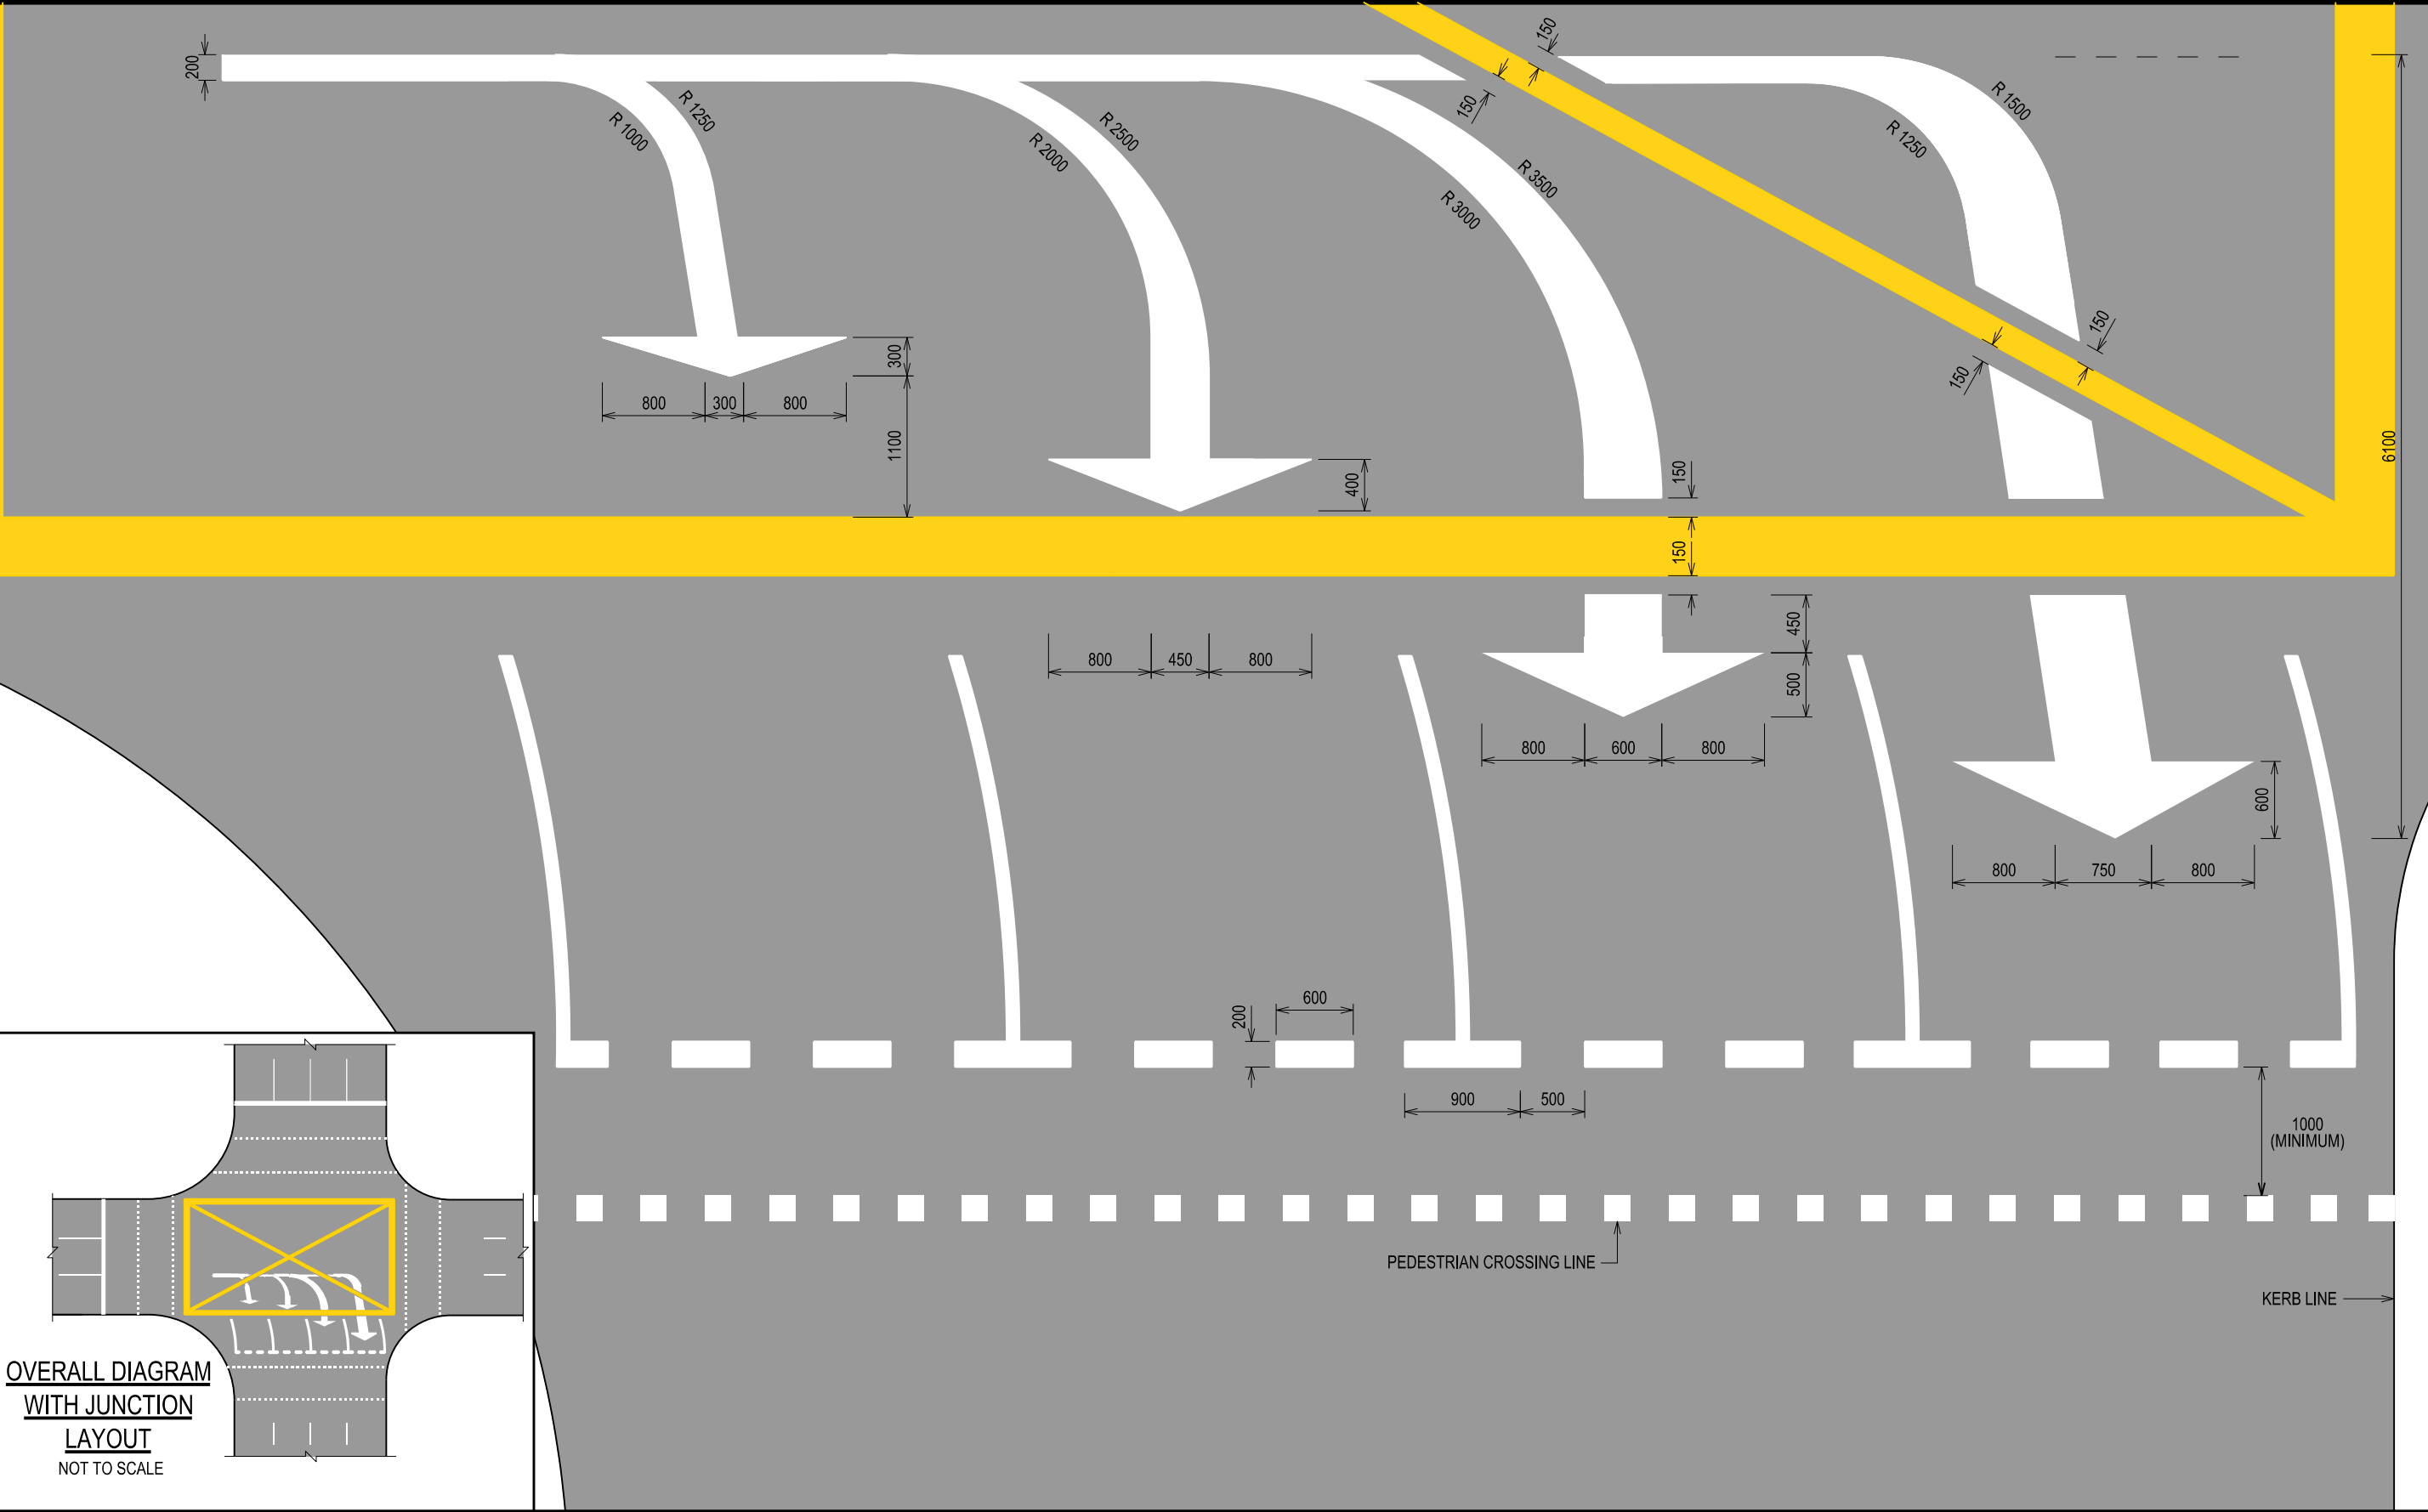


NOTES: 1. Thickness of thermoplastic paint is 3mm.		STANDARD DETAIL			
				DRAWING NO. LTA/SDRE14/8/RMS5	
				DATE OF ISSUE 1st APR 2014	SHEET NO. 1 OF 1
				SCALE 1:50	REV. A
		MULTI-HEAD ARROW FOR TURNING MOVEMENTS			
		A OCT 2015			
		REV. DATE			

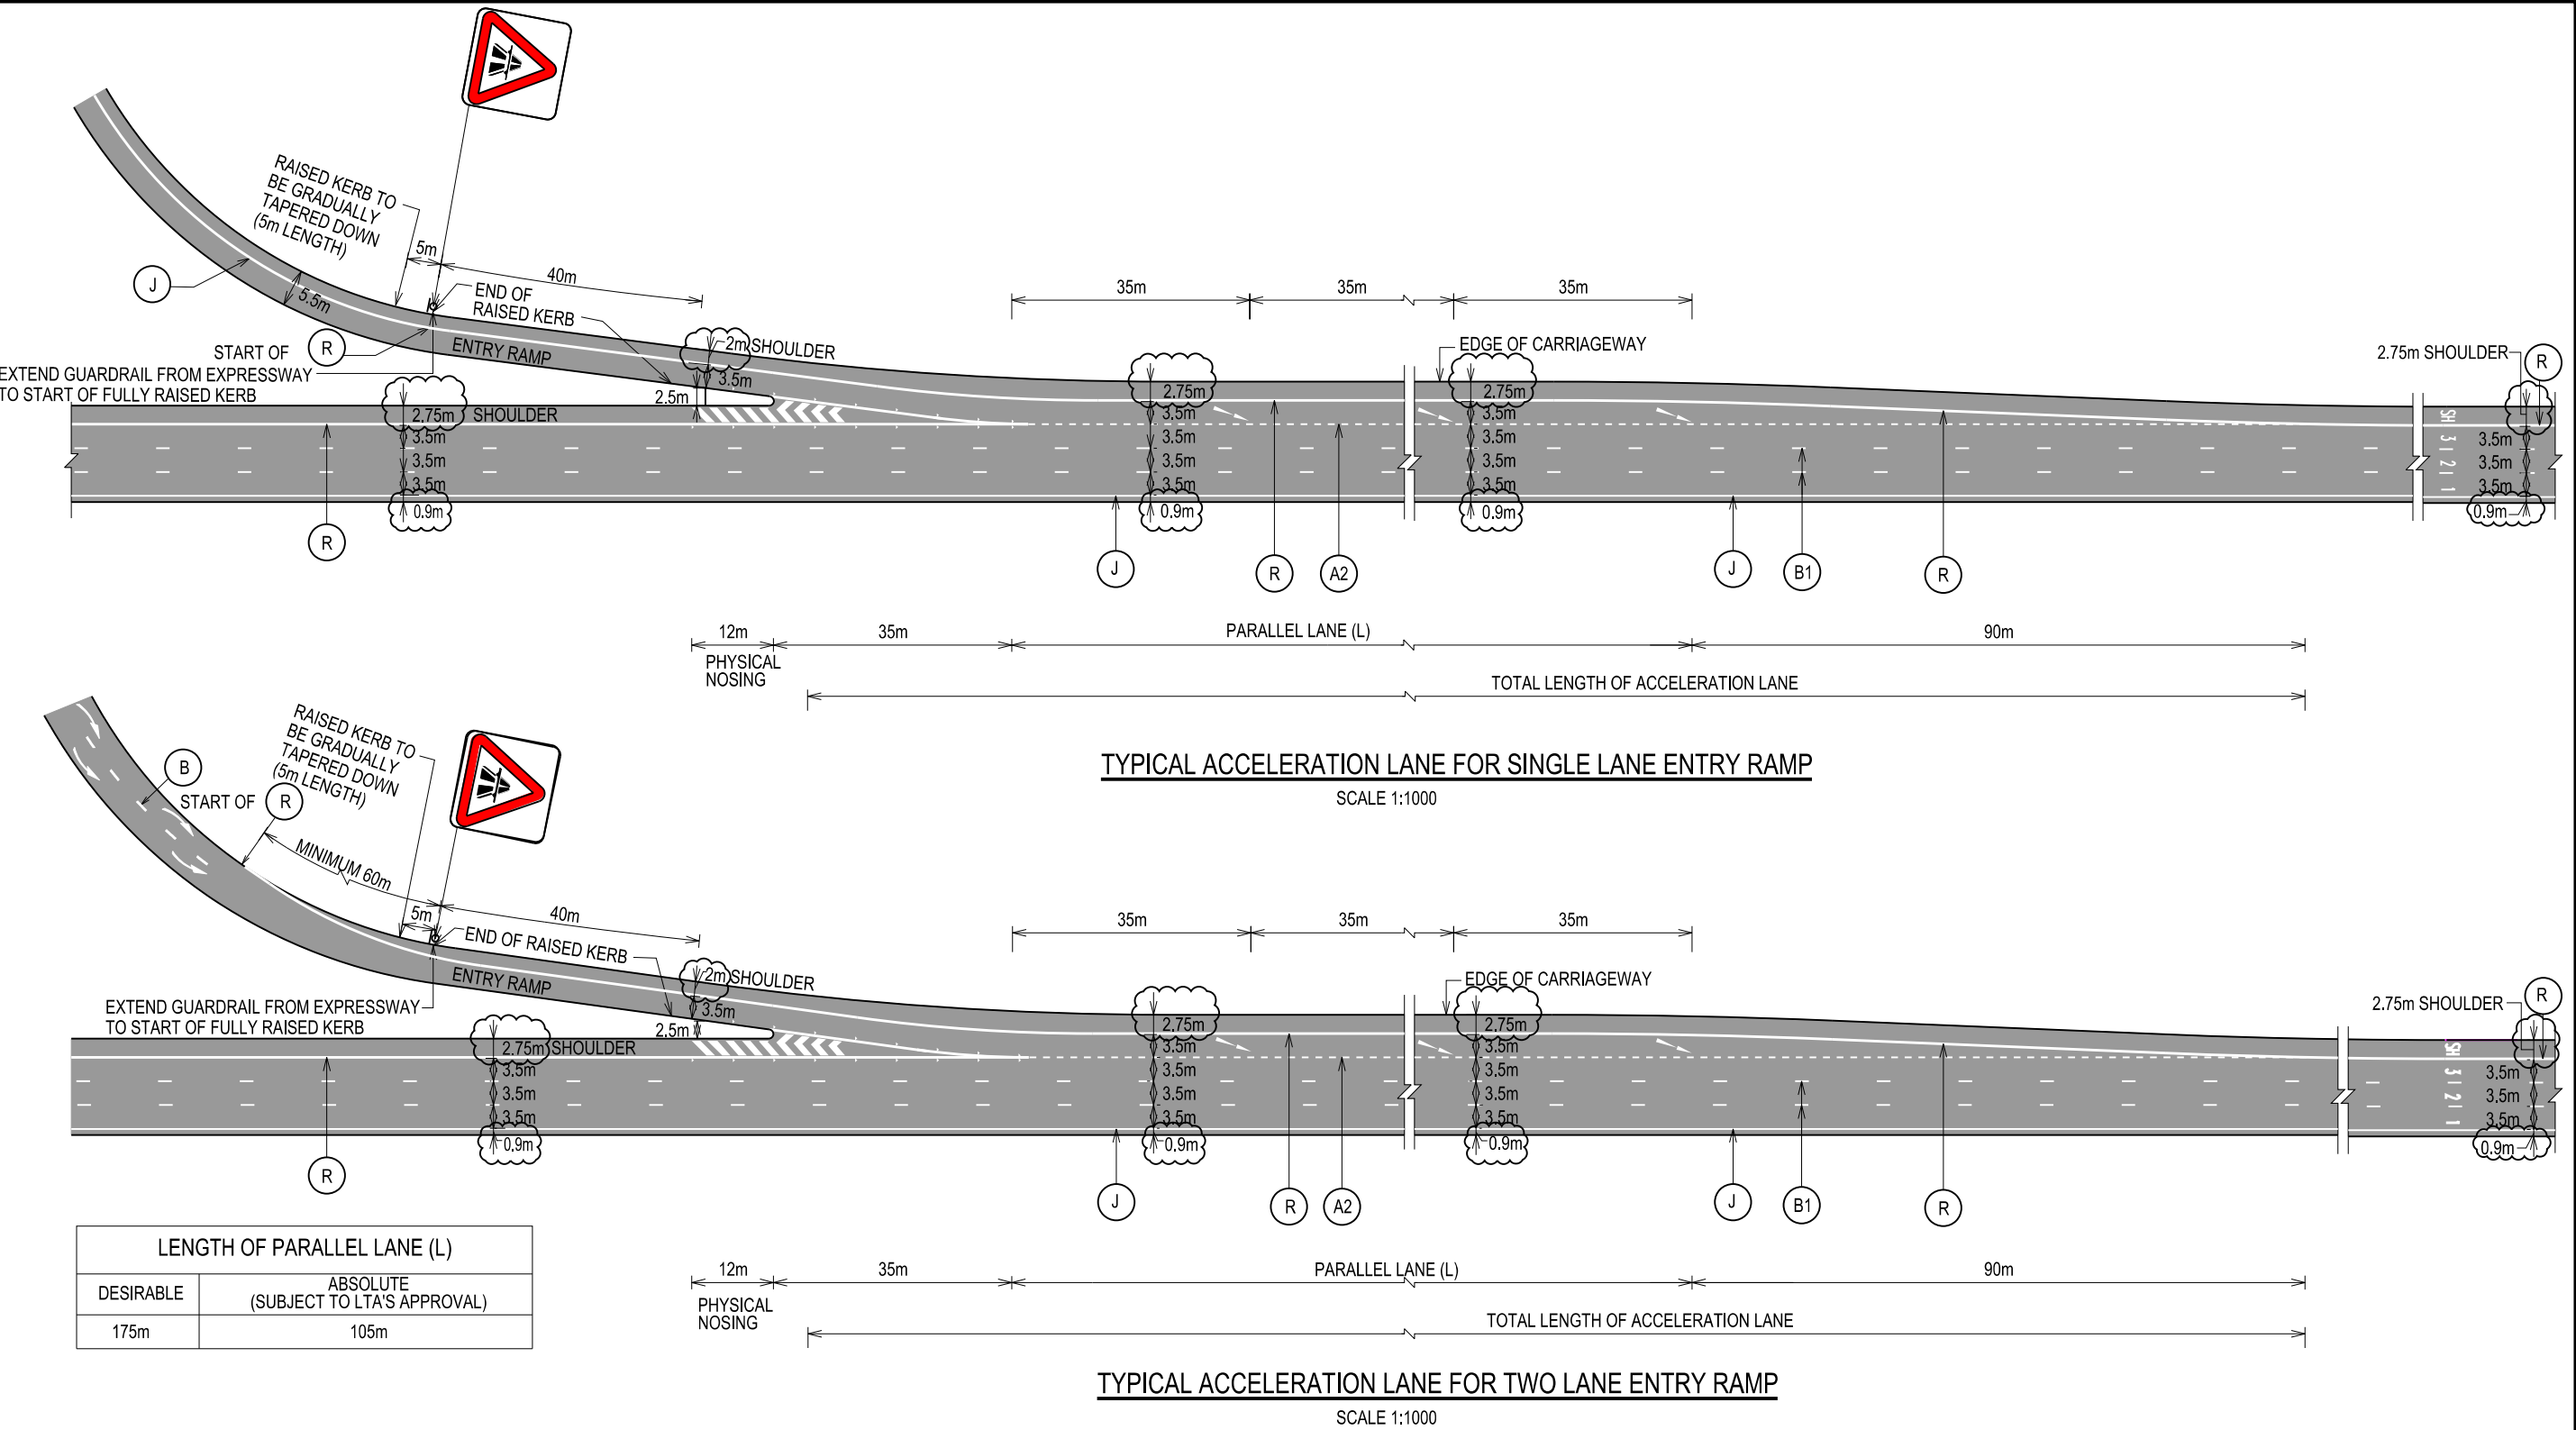


NOTES:
1. Appropriate width of the slip road shall be provided based on the various radii of the slip road, in accordance to Civil Design Criteria.

REV. DATE B APR 2024 A SEP 2017	STANDARD DETAIL	Land Transport Authority		
	TYPICAL ACCELERATION LANE AT EXPRESSWAY			DRAWING NO. LTA/SDRE14/8/RMS6
		DATE OF ISSUE 1st APR 2014	SCALE AS SHOWN	REV. B
		SHEET NO. 1 of 2		

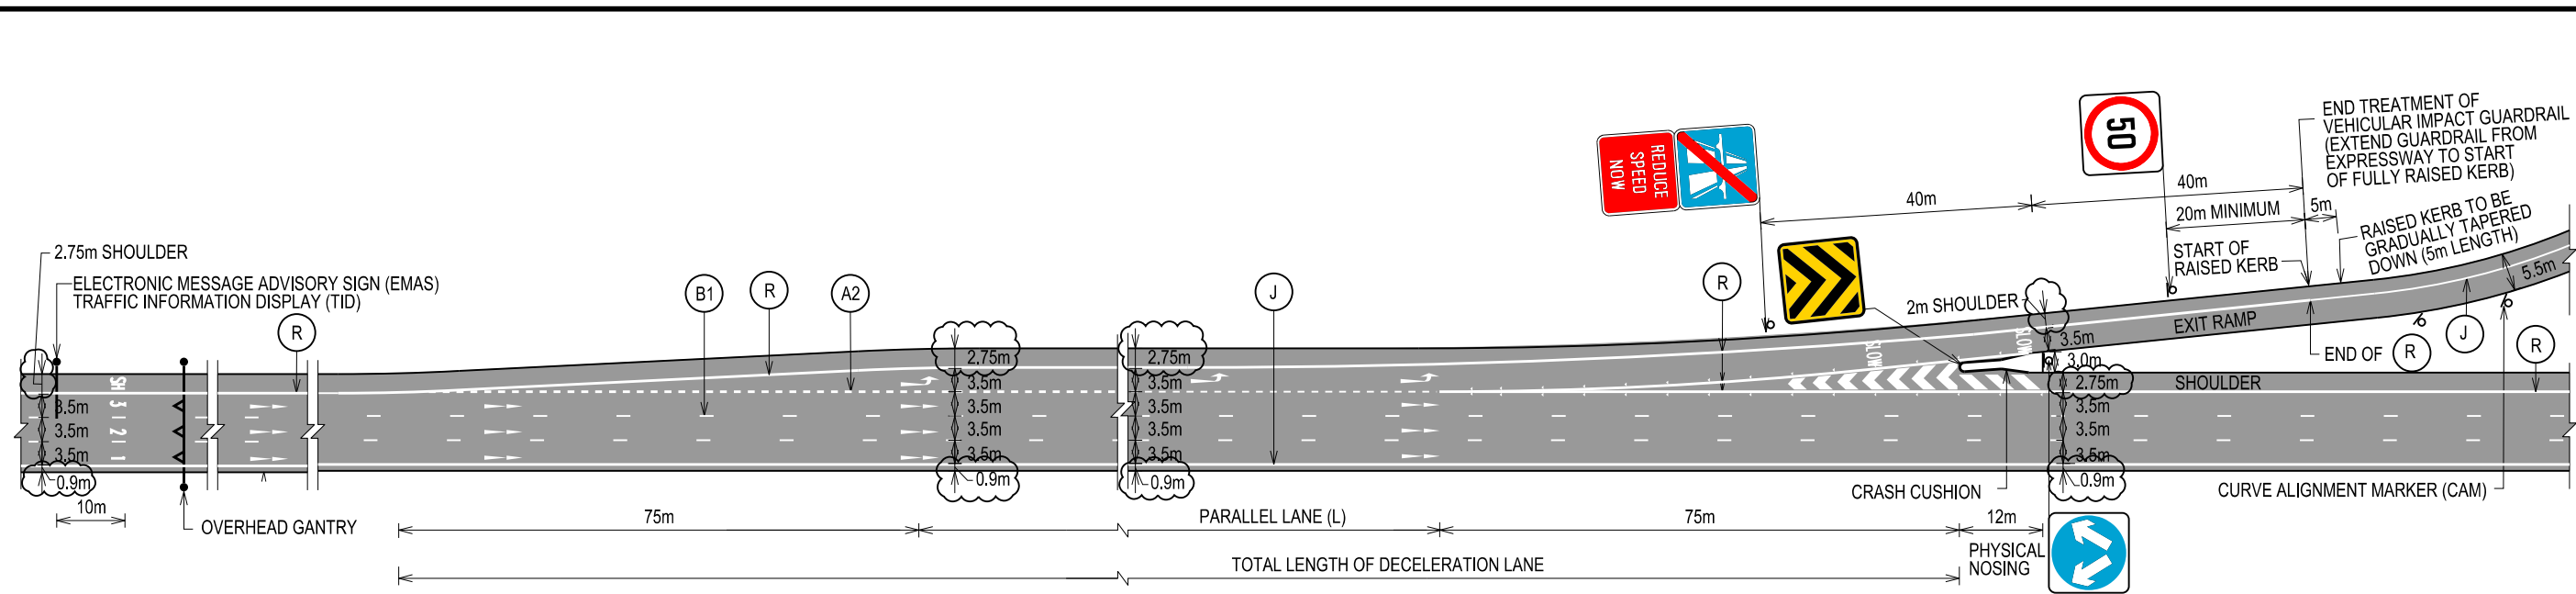

TYPICAL DECELERATION LANE AT EXIT FOR SINGLE LANE EXIT RAMP

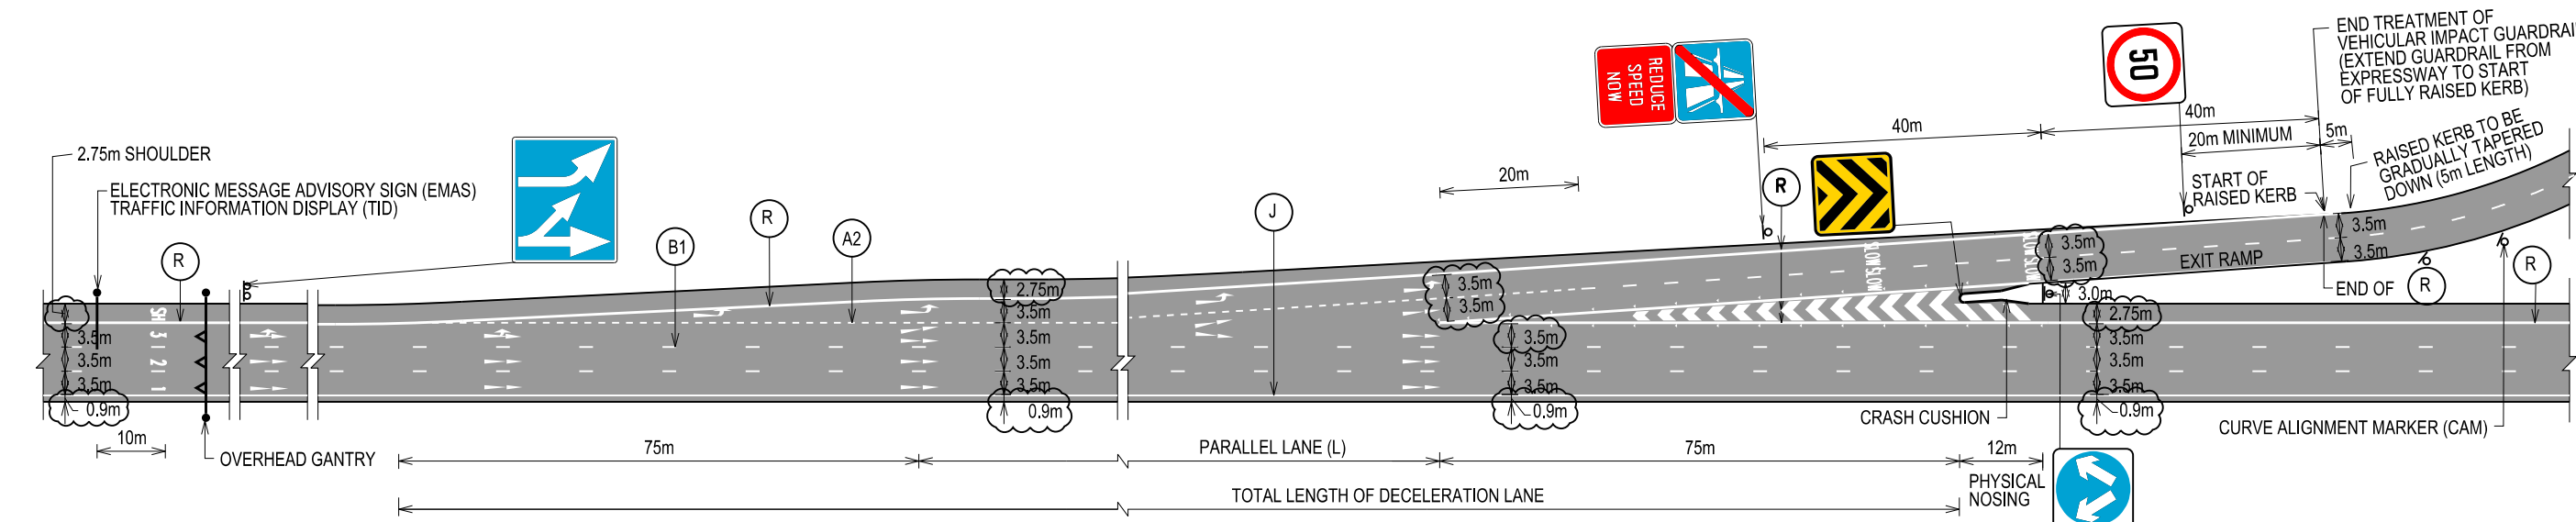



TYPICAL DECELERATION LANE AT EXIT FOR TWO LANE EXIT RAMP

LENGTH OF PARALLEL LANE (L)		
DESIRABLE	MINIMUM	ABSOLUTE (SUBJECT TO LTA'S APPROVAL)
150m	80m	10m

NOTES:




- Area between the slip road and main road behind the nosing shall be graded level with carriageway and shall be free of signs, trees, lamp posts and other hard objects except split arrows and object marker sign.
- Total length of the deceleration lane can be further reduced to absolute minimum value of 160m due to site constraint subject to approval by LTA.
- Appropriate width of the slip road shall be provided based on the various radii of slip road, in accordance to Civil Design Criteria.

REV.	DATE	B APR 2024 A SEP 2017	STANDARD DETAIL TYPICAL DECELERATION LANE AT EXPRESSWAY	Land Transport Authority		
				DRAWING NO. LTA/SDRE14/8/RMS7		
				REV. B		
				DATE OF ISSUE 1st APR 2014	SCALE 1:1000	SHEET NO. 2 of 2

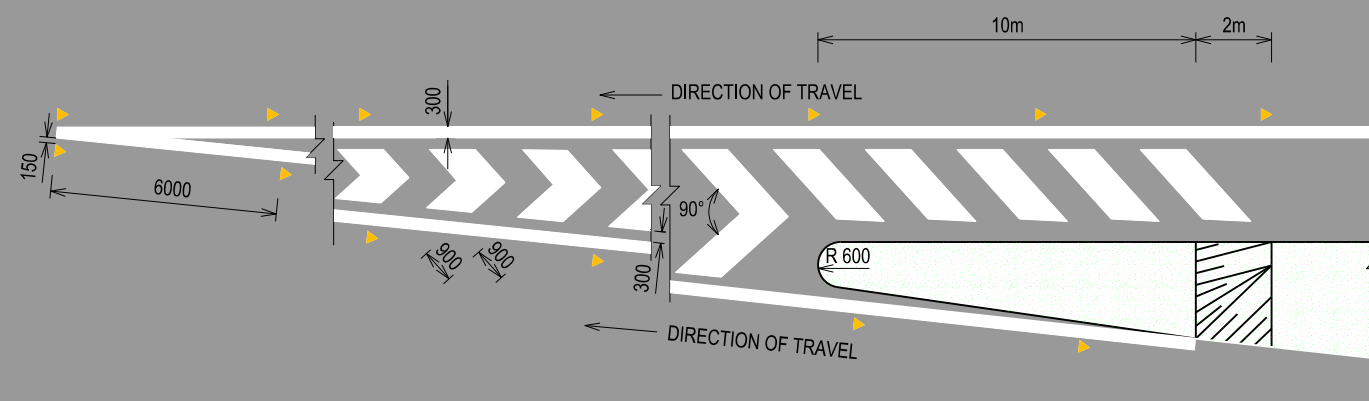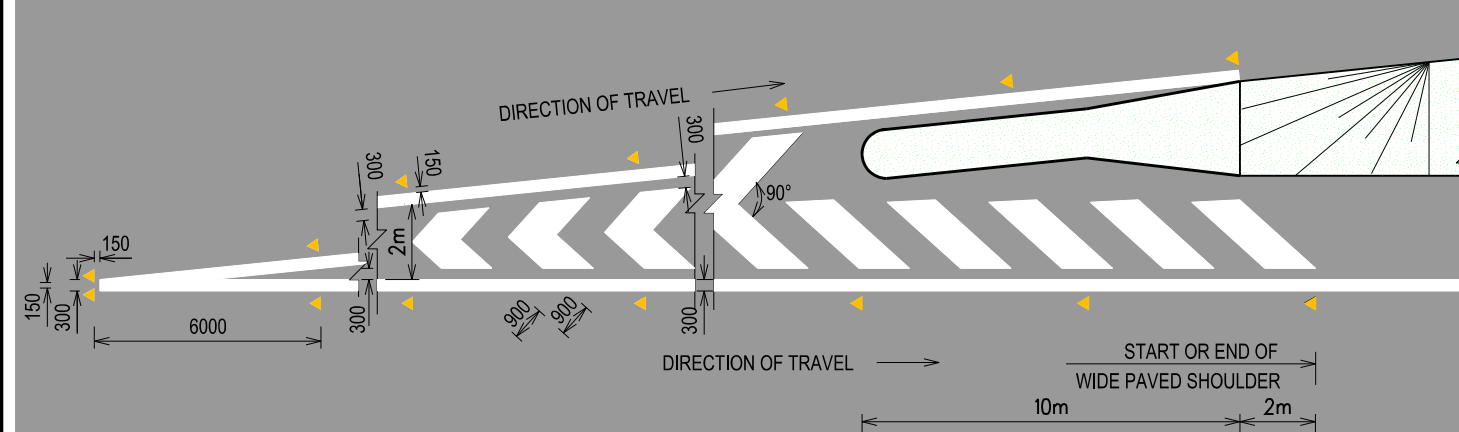

LEGEND :


▶ RAISED REFLECTIVE PAVEMENT MARKERS (AMBER)

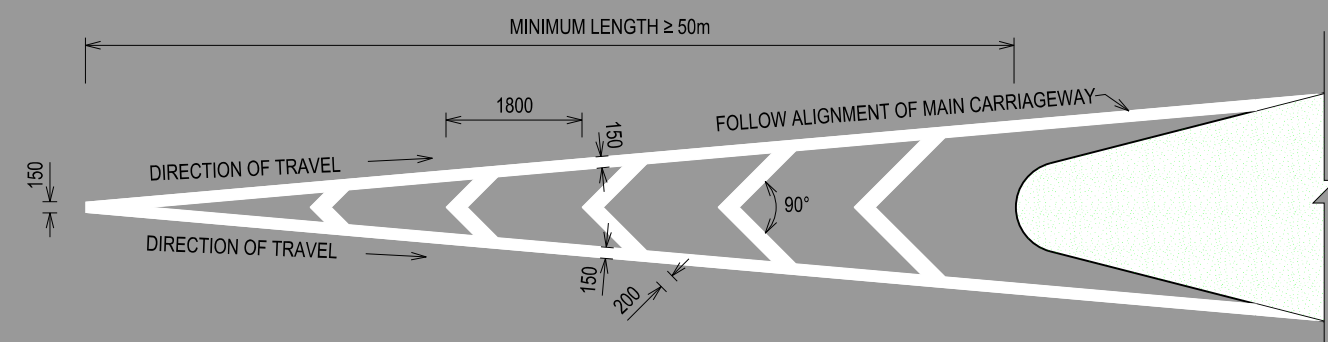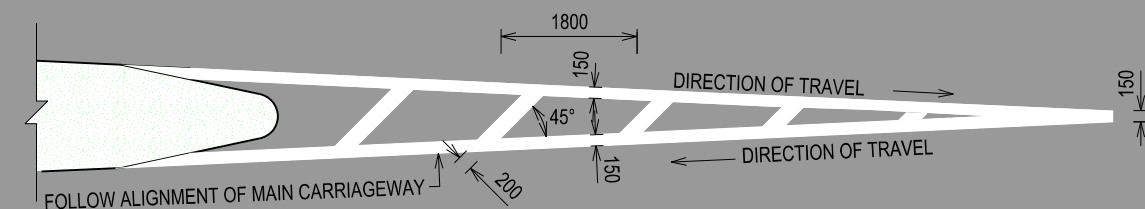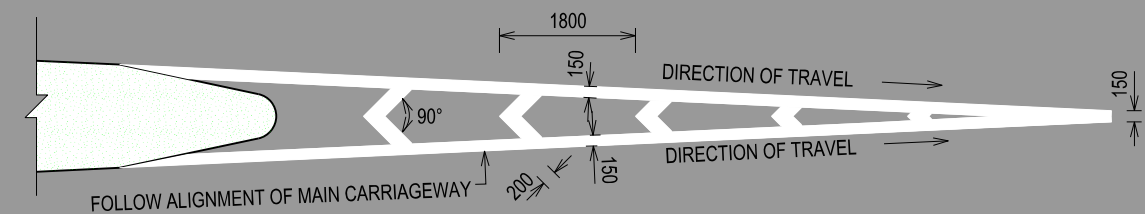

NOTES:

1. The raised reflective pavement markers shall be complied with the requirements laid down in BS 8442:2006, BS EN 12899-1:2007, BS EN 1463-1:2009.
2. Thickness of thermoplastic paint is 3mm.

--	--	
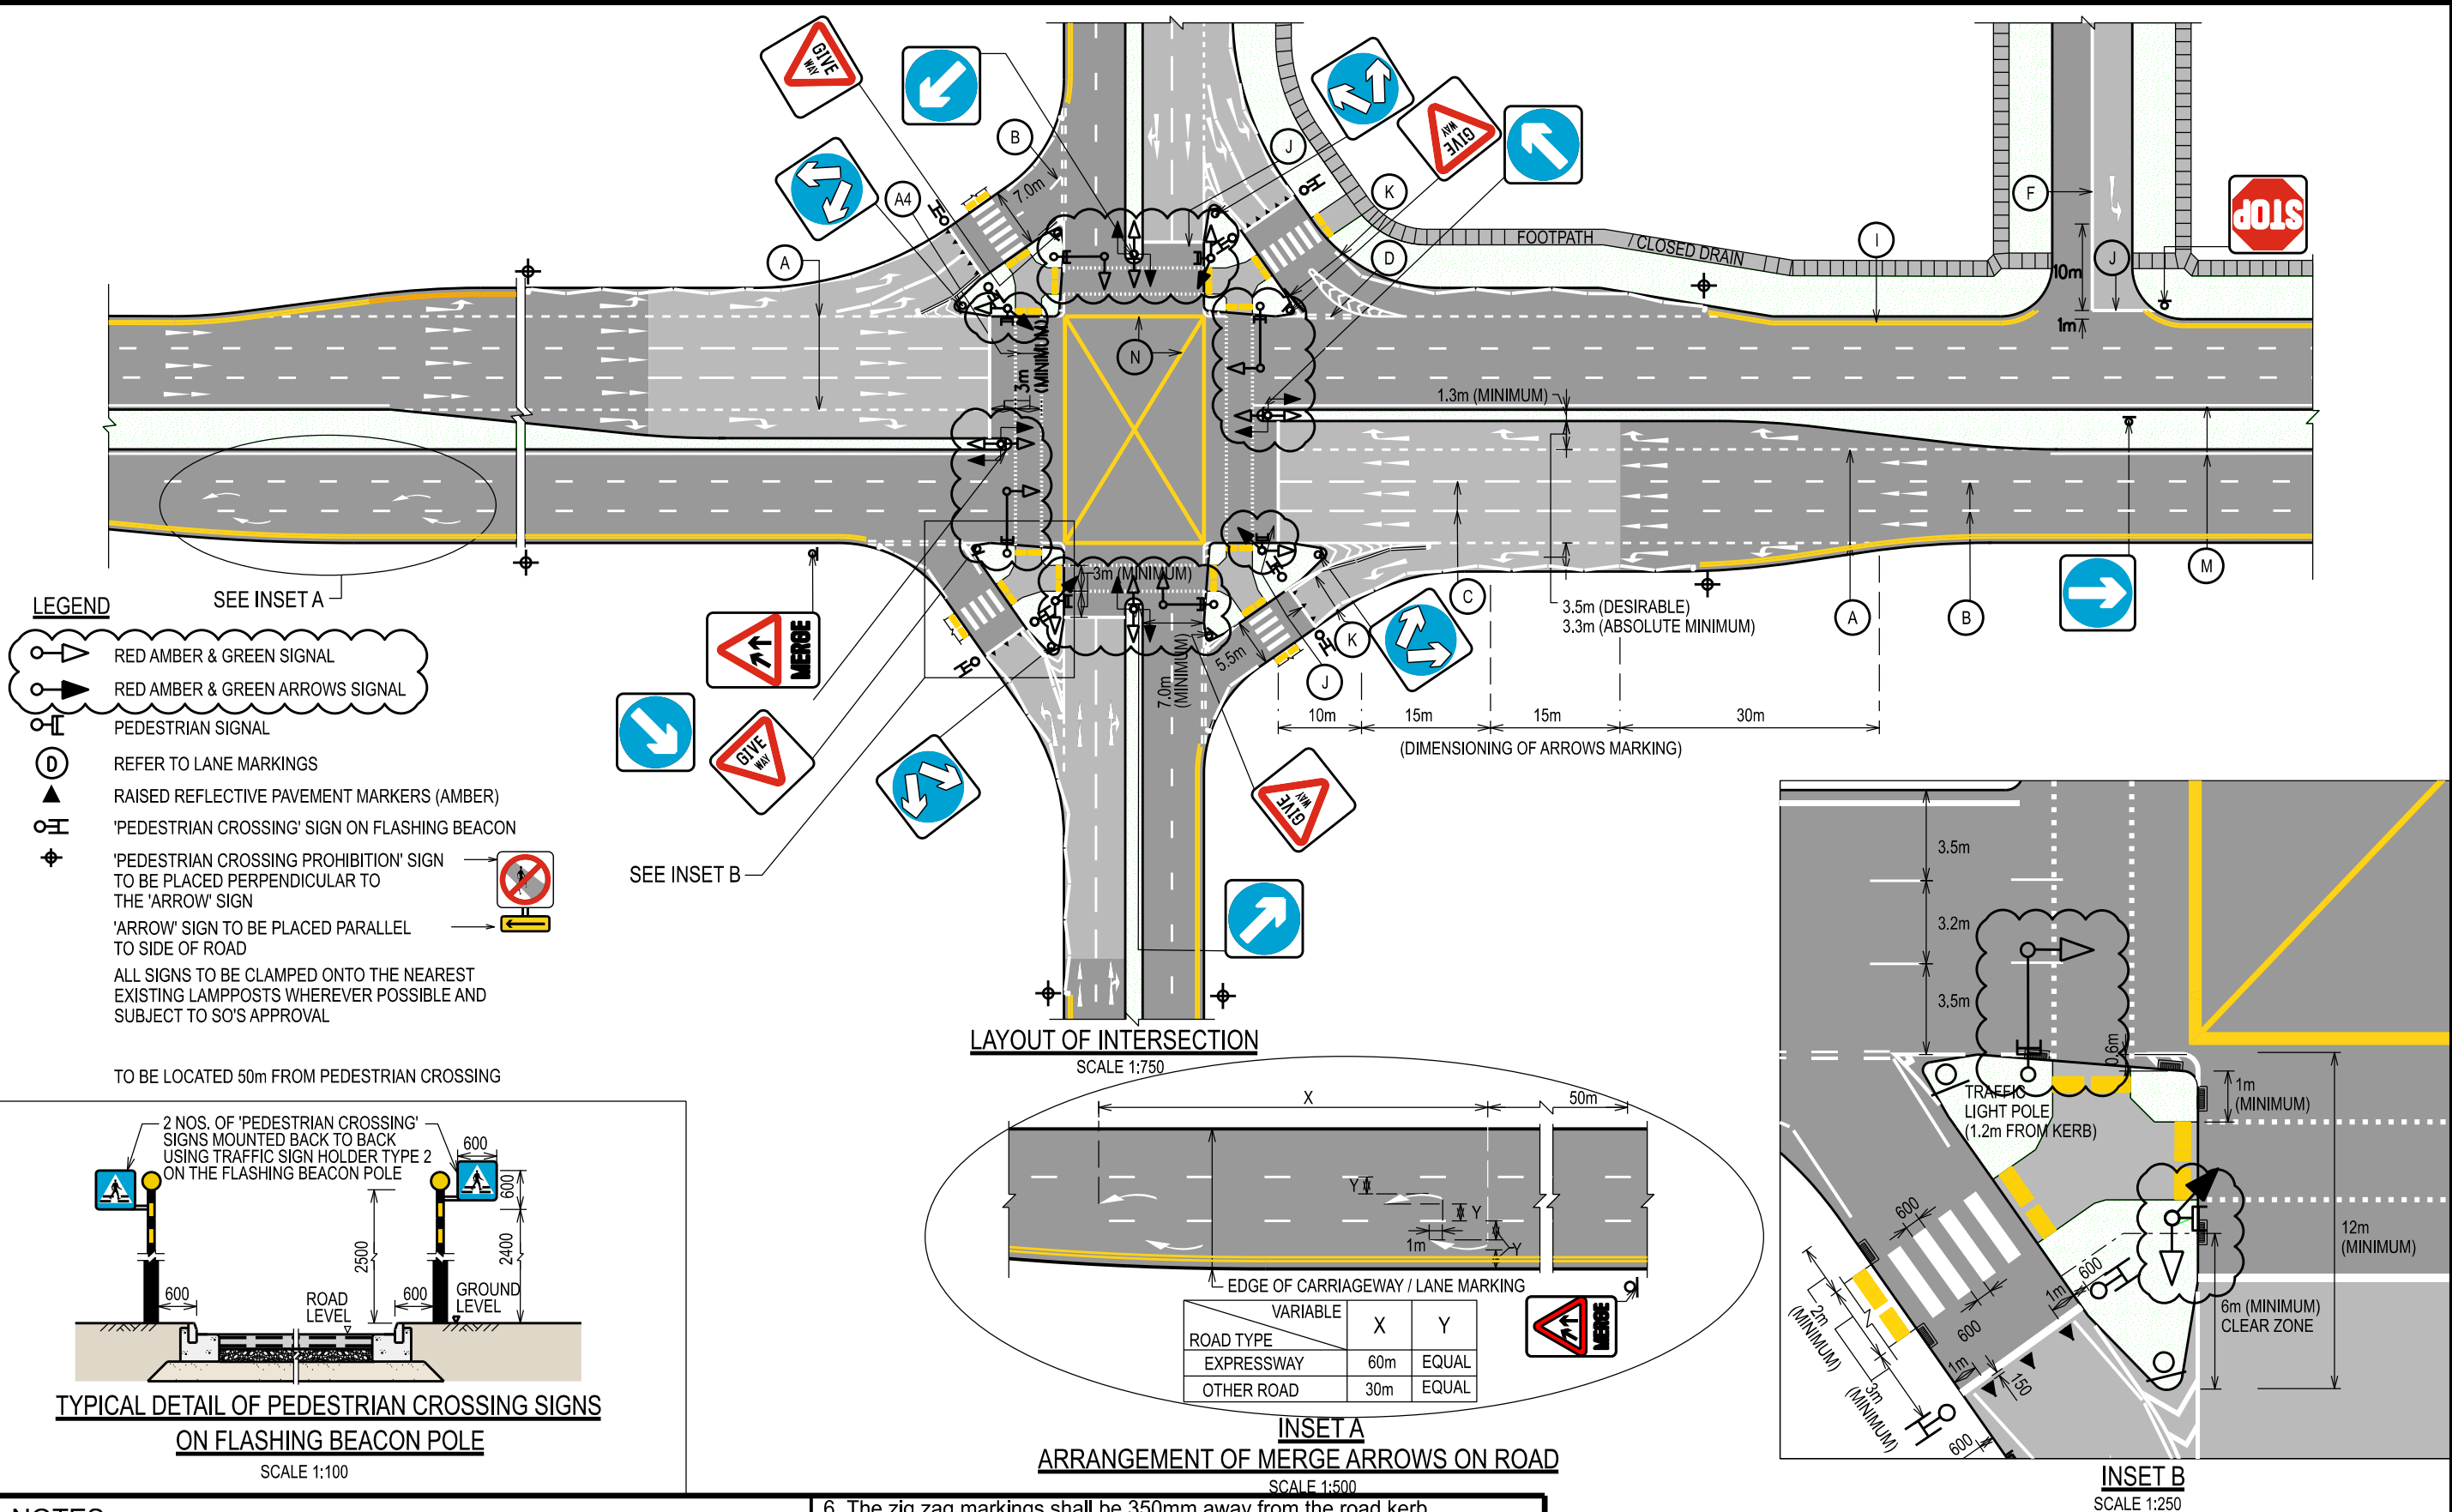


NOTES:




- For pedestrian crossing with green and red man aspect, crossing is to be painted white.
- For pedestrian crossing without green and red man aspect, crossing is to be painted yellow.
- However, where site condition necessitates it, the stop line can be more than a metre from the mouth of the junction.
- If the width of centre median does not permit the erection of 'Keep Left' sign, spring-loaded delineator post shall be used.
- The zig zag markings must not overlap existing double yellow lines.

- The zig zag markings shall be 350mm away from the road kerb.
- The 'Pedestrian Crossing' sign shall face the oncoming traffic and erect away from the road kerb.
- The 'Pedestrian Crossing' sign is to be erected on existing lamppost / traffic light pole / any sign pole that is located less than 1m away from the flashing beacon pole.
- There shall be no additional loading on the flashing beacon pole other than 'Pedestrian Crossing' signs.
- Thickness of thermoplastic paint for zebra crossing marking is 3mm.
- Appropriate width of the slip road shall be provided based on the various radii of slip road, in accordance to civil design criteria.

STANDARD DETAIL		Land Transport Authority		
ROAD SIGNS & MARKINGS AND TRAFFIC SIGNAL PLACEMENT		DRAWING NO. LTA/SDRE14/8/RMS9		REV. F
		DATE OF ISSUE 1st APR 2014	SCALE AS SHOWN	SHEET NO. 1 OF 1
		REV. DATE		
F	MAR 2025			
E	APR 2024			
D	APR 2022			
C	APR 2019			
B	SEP 2017			
A	OCT 2015			

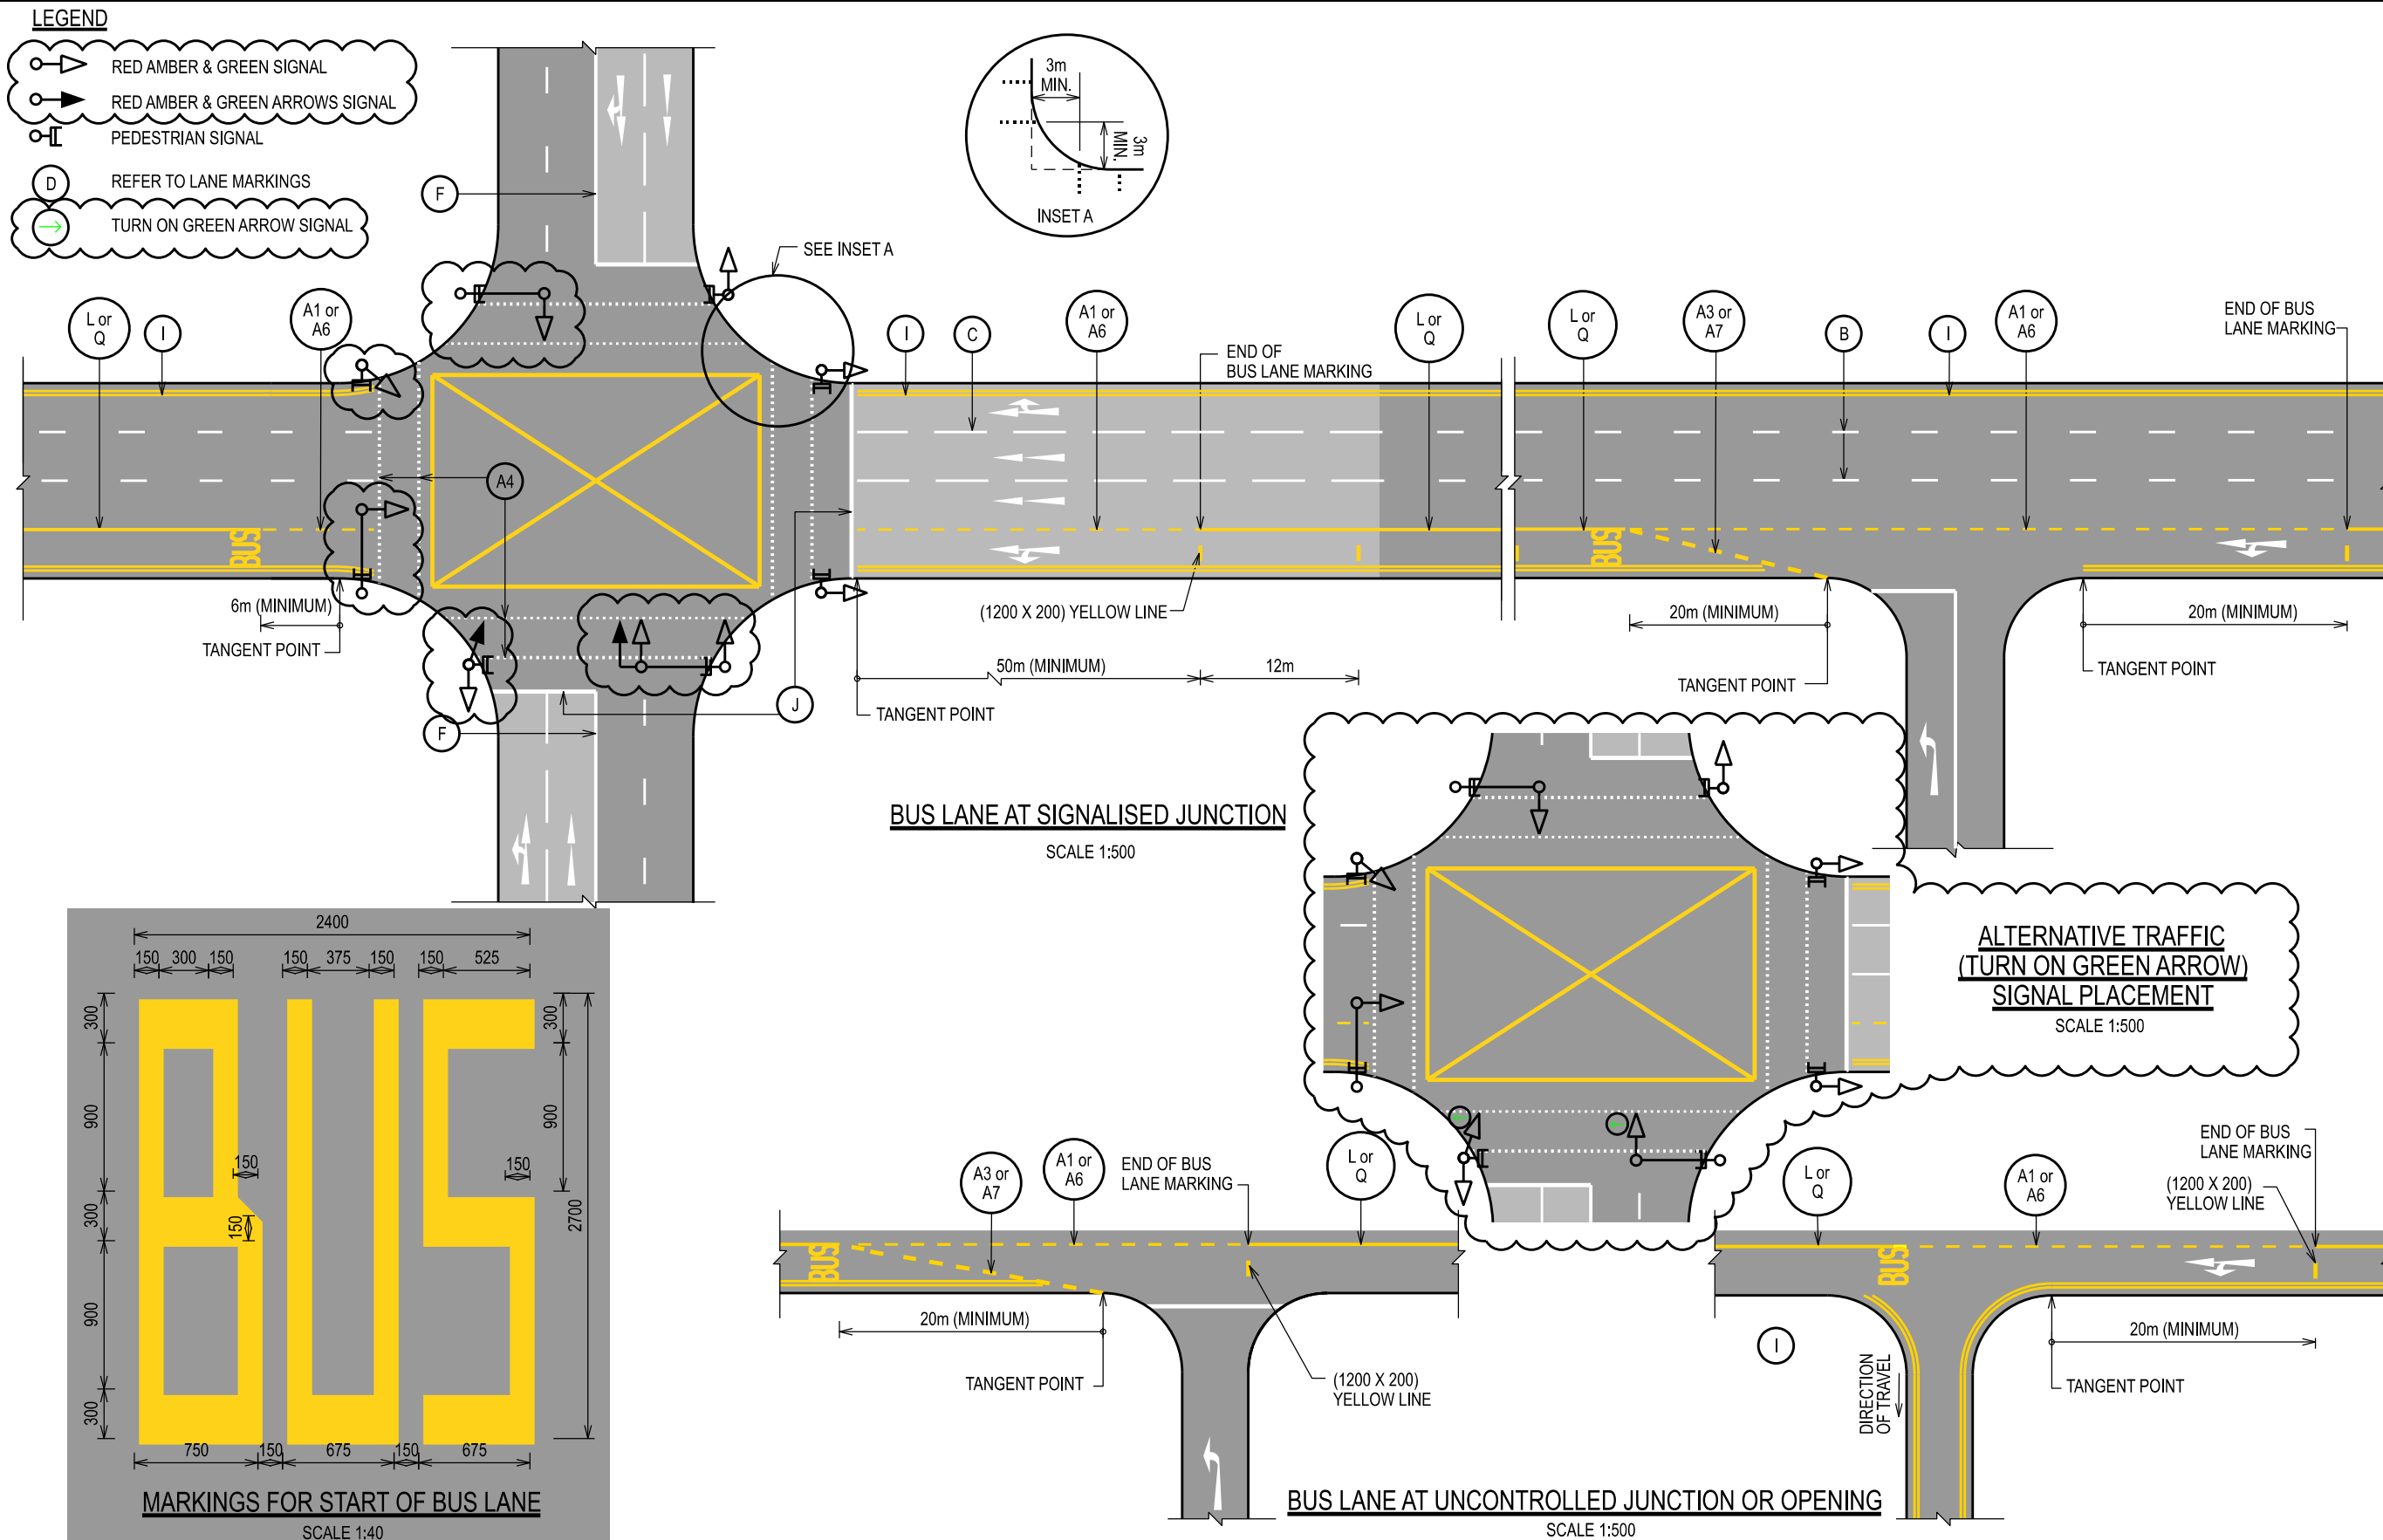

STANDARD DETAIL		Land Transport Authority		
D C B A REV.	MAR 2025	BUS LANE MARKINGS AND ALTERNATIVE TRAFFIC (TURN ON GREEN ARROW) SIGNAL PLACEMENT		DRAWING NO. LTA/SDRE14/8/RMS10 REV. D
	APR 2019			
	SEP 2017			
	OCT 2015			
	DATE			
		DATE OF ISSUE 1st APR 2014	SCALE AS SHOWN	SHEET NO. 1 OF 1

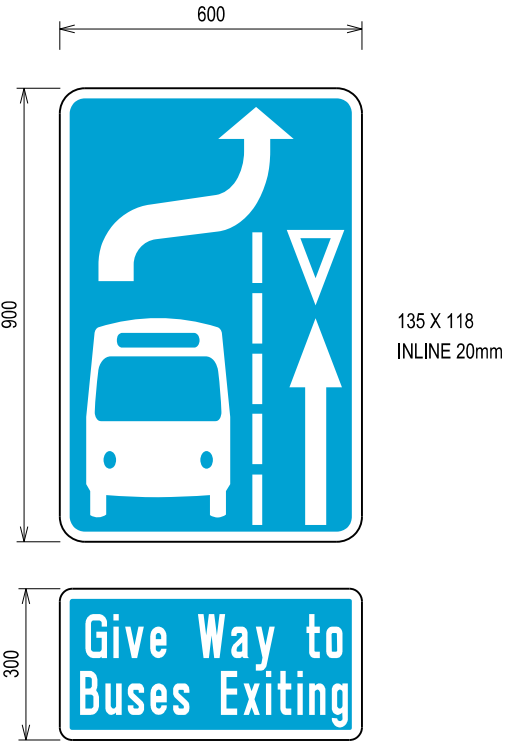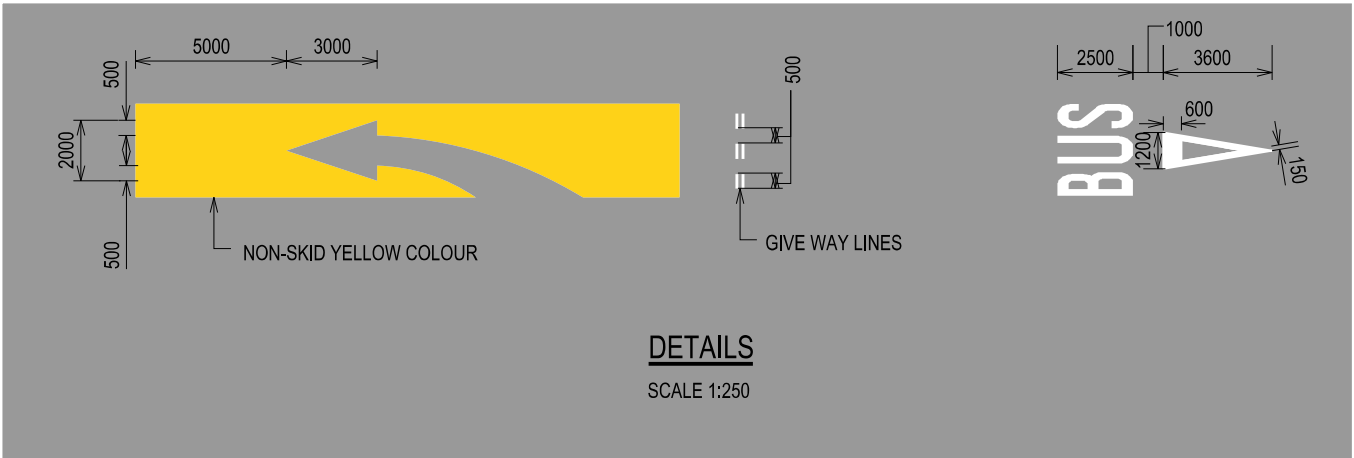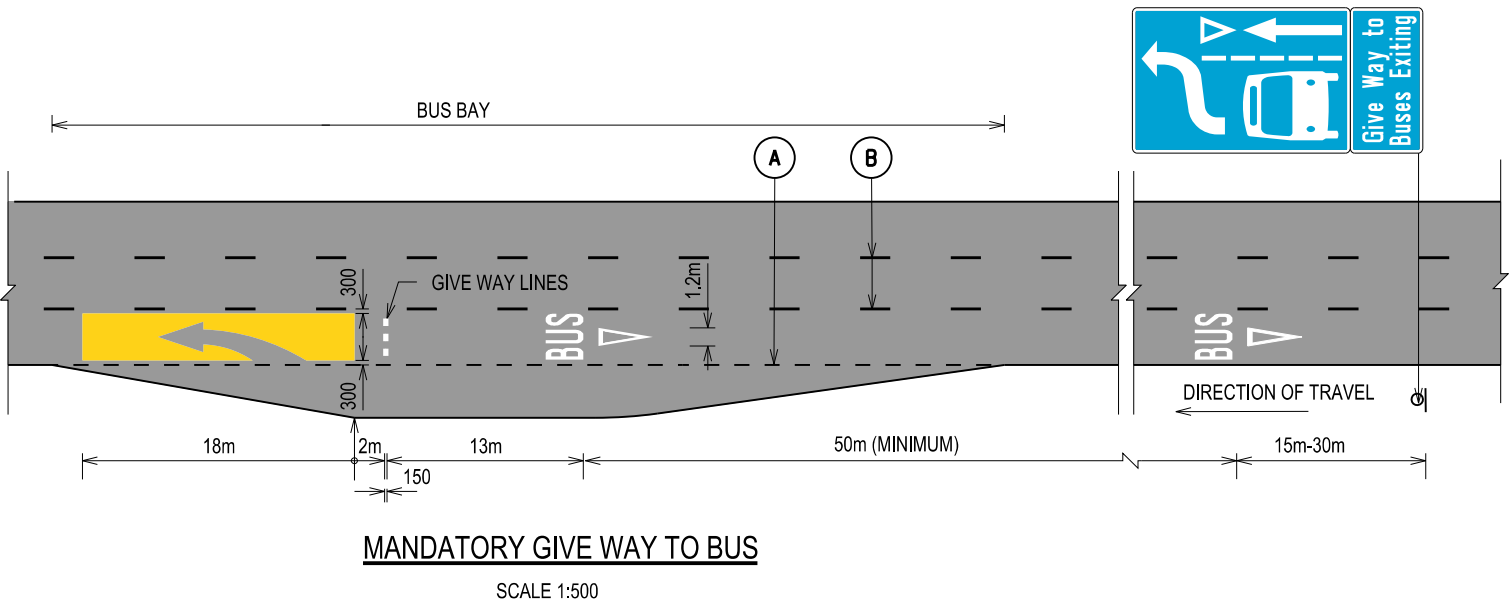

'MANDATORY GIVE WAY TO BUS' SIGN

SCALE 1:15


NOTES:

1. Colour code for the Bus Zone shall be of "BS 381C 355 LEMON" or equivalent for the section to be coated with yellow.


																																																																																																																																																																																																																																																																																																																																																																																																																																																																																																																																																																																																																																																																																																																																																																																																																																																																																																																																																																																																																																																																																																																																																																																																																																																																																																																																																																																																																					</
--	--	----

LEGEND

- D REFER TO LANE MARKINGS
- ◆ DOUBLE AMBER RAISED REFLECTIVE PAVEMENT MARKERS

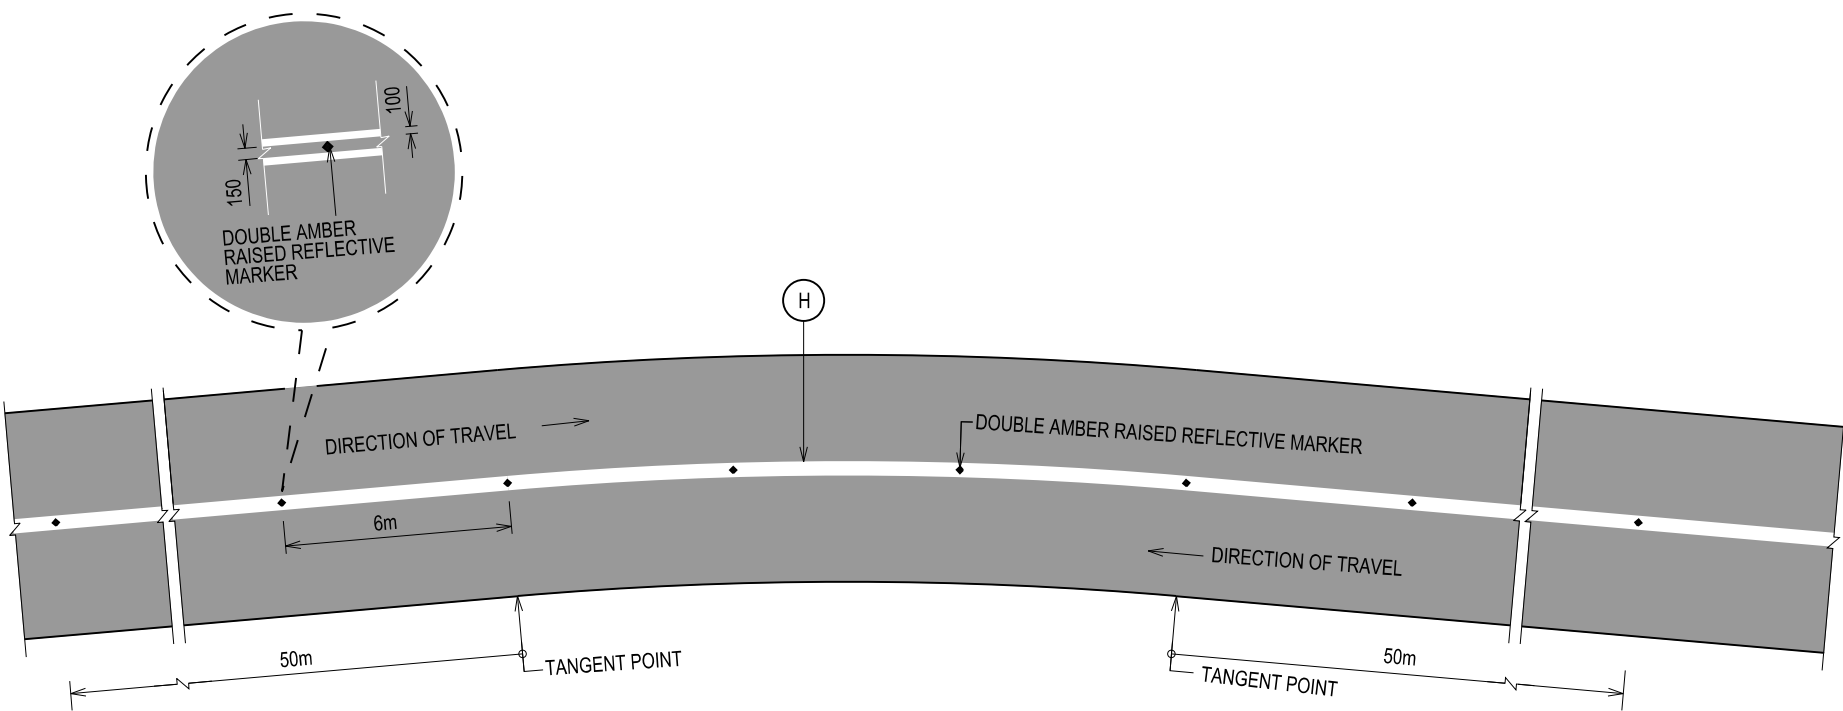

RAISED REFLECTIVE PAVEMENT MARKERS AT SHARP CURVE (AT 6m INTERVAL)
SCALE 1:200

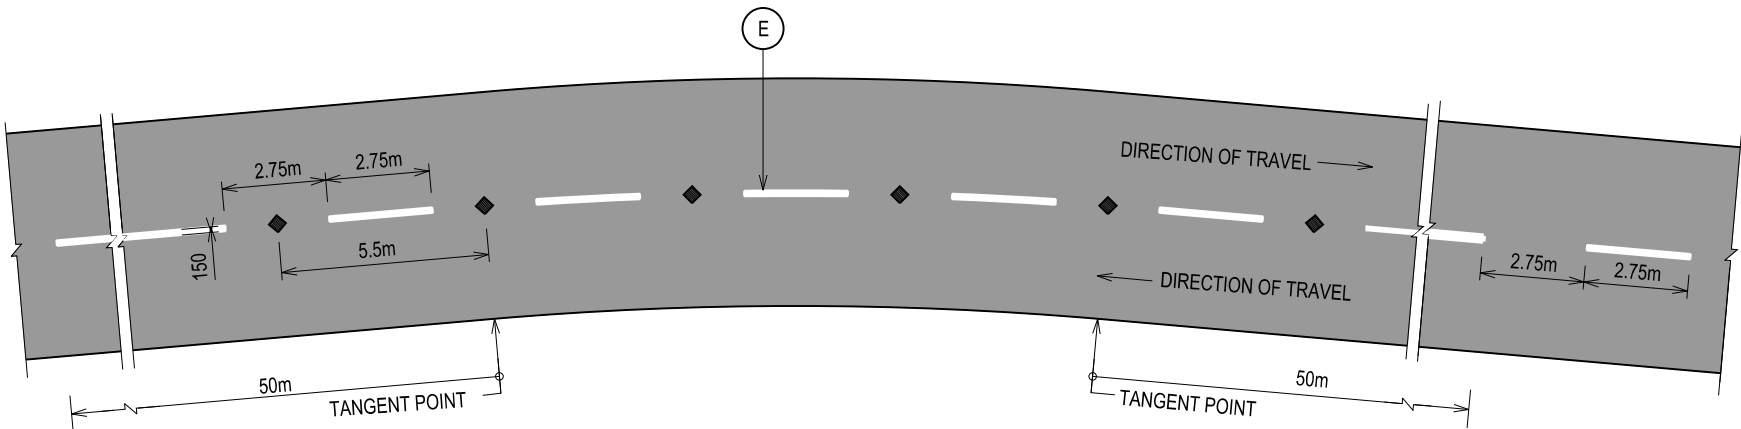

RAISED REFLECTIVE PAVEMENT MARKERS AT SHARP CURVE (AT 5.5m INTERVAL)
SCALE 1:200

NOTES:

1. The raised reflective pavement markers shall comply with BS 8442:2006, BS EN 12899-1:2007, BS EN 1463-1:2009.
2. Sharp curve refers to radius equal to or less than 200m.

--	--	
TABLE 1:
SIZE OF CURVE ALIGNMENT MARKER (CAM)


CLASS OF ROAD	SIZE OF CAM	REMARKS
EXPRESSWAY	750 X 900	HEIGHT CLEARANCE OF THE CURVE ALIGNMENT MARKER SHALL NOT BE MORE THAN 1.2m FROM THE GROUND TO THE BOTTOM OF THE MARKER. IF CURVE ALIGNMENT MARKER MOUNTED ON VIADUCT, HEIGHT CLEARANCE OF THE CURVE ALIGNMENT MARKER SHALL BE 1.5m.
OTHER ROAD	600 X 750	

TABLE 2:
SPACING OF CURVE ALIGNMENT MARKER (CAM) FOR EXPRESSWAY


RADIUS OF CURVE - R (m)	SPACING OF CURVE ALIGNMENT MARKERS - X (m)
45	9
60	11
75	12
90	15
120	17
150	20
180	21
210	23
240	24
270	26
300	27

TABLE 3:
SPACING OF CURVE ALIGNMENT MARKER (CAM) FOR OTHER ROAD


RADIUS OF CURVE - Y (m)	SPACING OF CURVE ALIGNMENT MARKERS - Z (m)
< 50	14
50 - 100	16
101 - 150	24
> 150	32

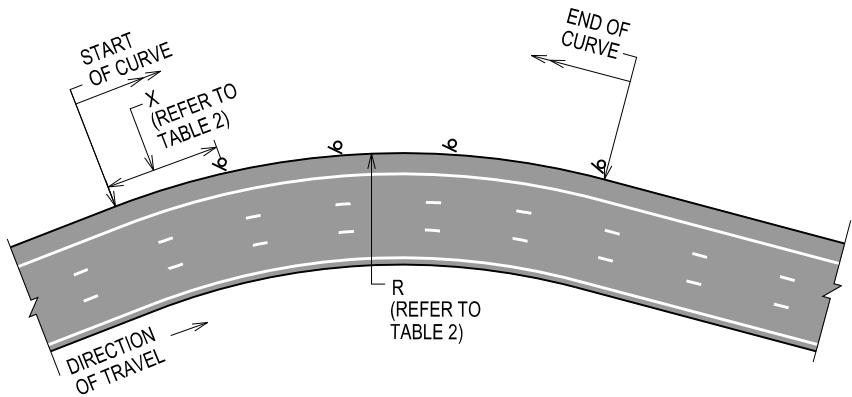

CURVE ALIGNMENT MARKER FOR EXPRESSWAY

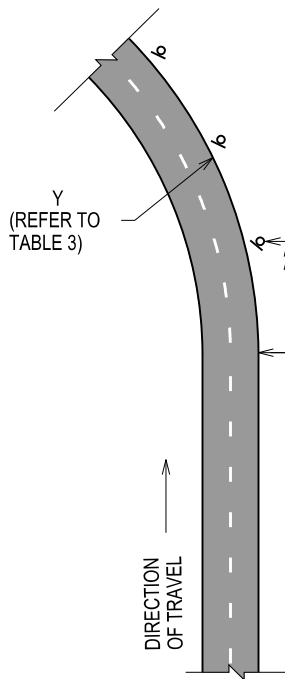

TYPICAL HORIZONTAL CURVE (ONE WAY)

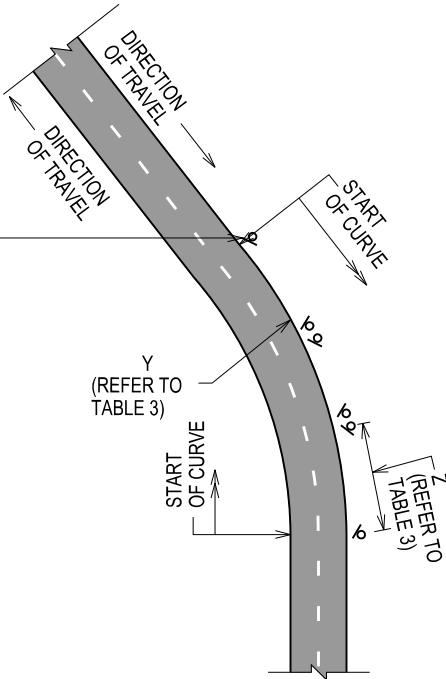

TYPICAL HORIZONTAL CURVE (TWO WAY)


CURVE ALIGNMENT MARKER FOR OTHER ROAD

NOTES:

- The first CAM shall be placed at a distance of one spacing after the start of the curve for all roads.
- Last CAM shall be placed at the end of the curve with intermediate CAM equally placed.
- CAM are mandatory for curves with radius less than
 - 95m for roads of posted speed limit of 70km/h.
 - 60m for roads of posted speed limit of 60km/h.CAM may be installed for larger radius curve at the discretion of the authority.

4. Minimum three CAM are to be installed at each approach.


STANDARD DETAIL		Land Transport Authority		
CURVE ALIGNMENT MARKERS (CAM)	REV.	DATE	DRAWING NO.	REV.
			LTA/SDRE14/8/RMS13	-
			DATE OF ISSUE	SHEET NO.
			1st APR 2014	1 of 1
			SCALE	
			1:1000	

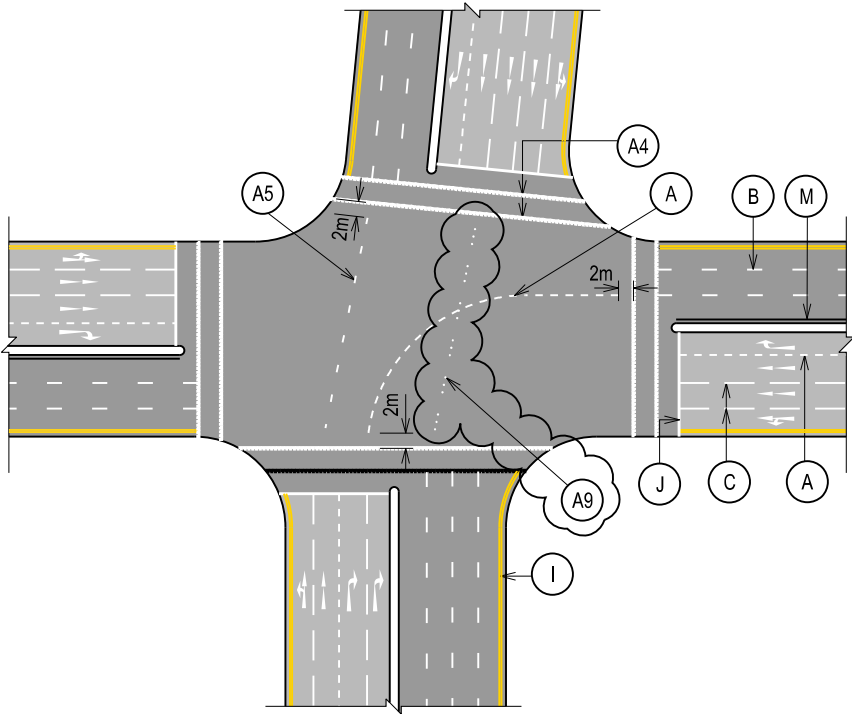

GUIDING LINES COULD BE APPLIED UNDER THE FOLLOWING SCENARIOS:
a) For skewed intersections or intersections with crest where the receiving lanes are not clearly seen by motorists and where it is not feasible to realign the intersections;
b) For complex intersections (usually large junctions) where motorists need to make right turn across more than 3 lanes (excluding exclusive right turn lane).


FIGURE 1
GUIDING LINES

SCALE 1:1000

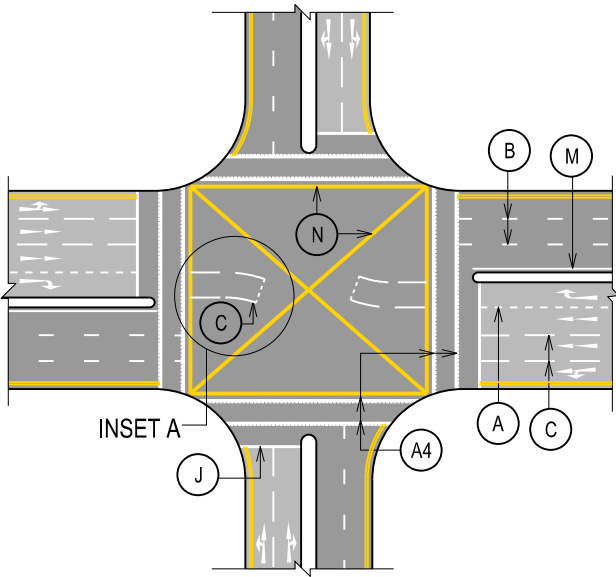


TYPICAL ONE LANE TURNING POCKET

SCALE 1:1000

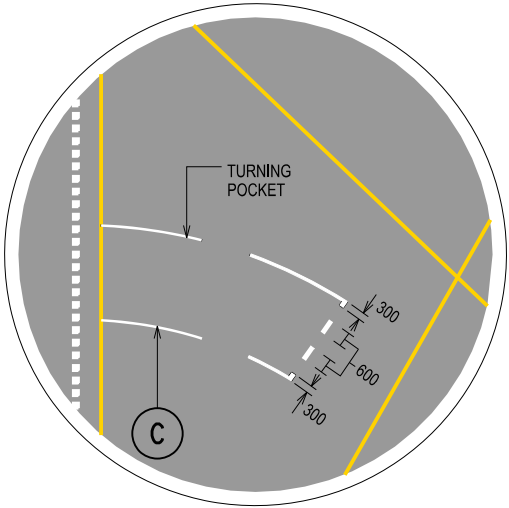


INSET A
NOT TO SCALE

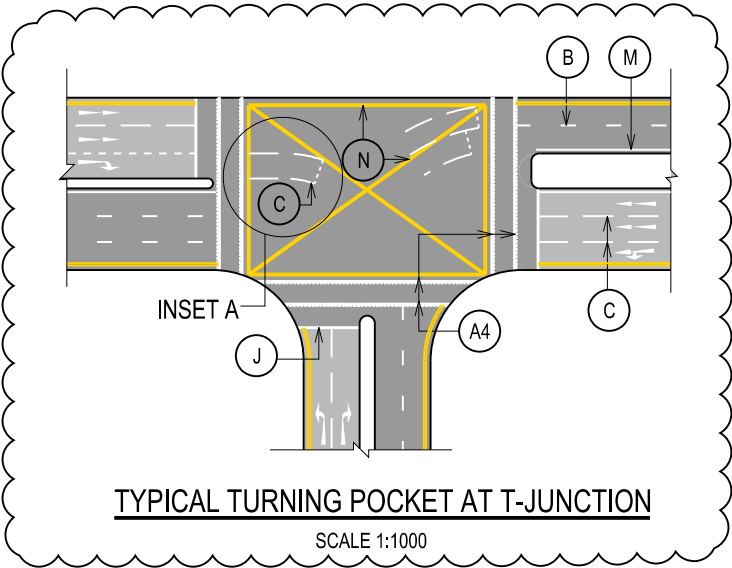

TYPICAL TURNING POCKET AT T-JUNCTION


SCALE 1:1000

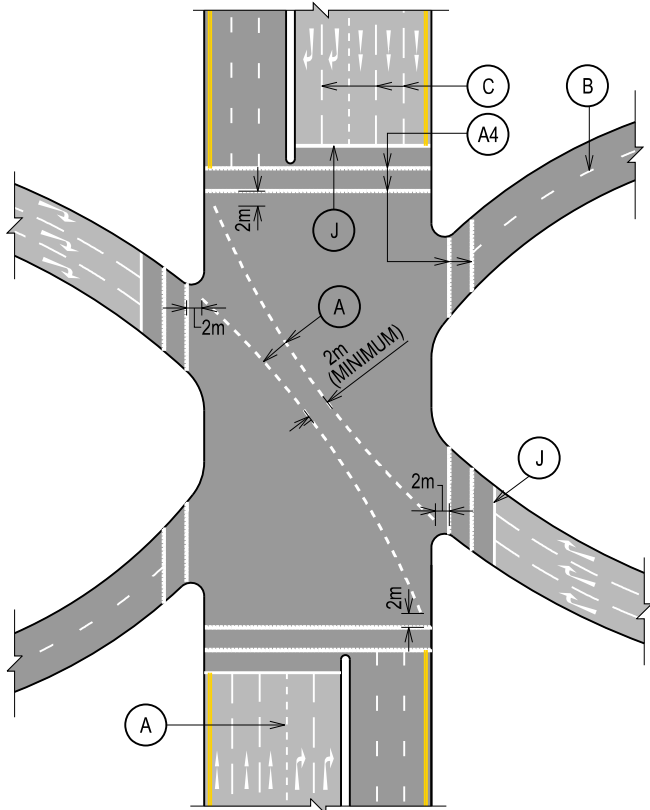

Boundary lines could be applied where there may be possible conflicts between two opposite turning traffic.

FIGURE 2
BOUNDARY LINES

SCALE 1:1000

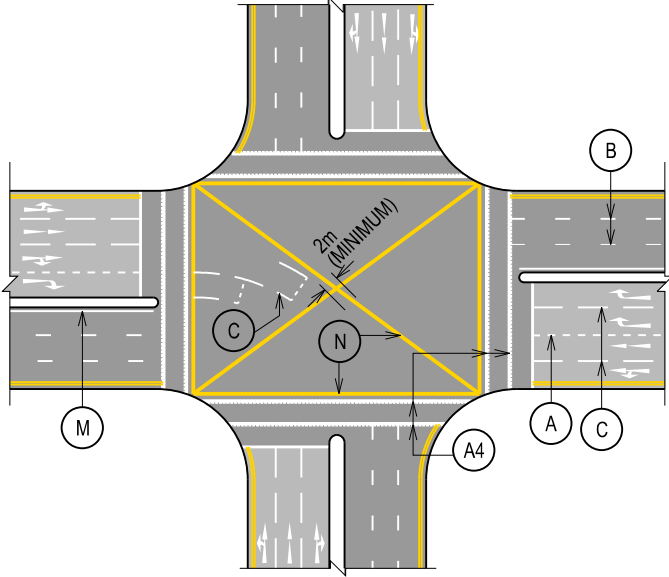

TYPICAL TWO LANE TURNING POCKET

SCALE 1:1000

NOTES:

1. For guiding lines at junctions:
a) Use Type A (1m mark, 1m gap) for primary turning movements;
b) Use Type A5 (1m mark, 3m gap) for through movements that does not intersect with (a);
c) Use Type A9 (2m set of 3 dots, 3m gap) for through movements that intersect with (a)

2. Guiding lines shall not recommended to be applied directly next to the pedestrian crossing lines where not possible, pedestrian crossing lines and or stop line may need to be offset (at least one lane width) from guiding line.
3. Guiding lines shall not intersect with existing turning pocket and shall not be drawn within turning pocket.
4. Guiding lines shall not be painted over yellow box markings.
5. The guiding line shall be provided based on the turning swept path for all vehicles.

STANDARD DETAIL

GUIDING LINES AND
TURNING POCKETS
AT INTERSECTIONS

Land Transport Authority

DRAWING NO.		REV.
LTA/SDRE14/8/RMS14		B
DATE OF ISSUE	SCALE	SHEET NO.
1st APR 2014	AS SHOWN	1 OF 1